

ALL PRINTED COPIES OF THIS DRAWING ARE CONSIDERED UNCONTROLLED

Avalon Controls Ltd

For

SNC-Lavalin-Dragados-Pennecon

# **ELECTRICAL EQUIPMENT CABIN A MANUFACTURING RECORD BOOK**


## **SECTION 3.3 – MECHANICAL MANUFACTURE DRAWINGS**

This document and all its contents remain the physical and intellectual property of Avalon Controls Limited and it shall not be copied or distributed without the consent of the company.

REV	DESCRIPTION	ORIGINATOR	REVIEW	APPROVAL	DATE
N/A	N/A	N/A	N/A	N/A	N/A

**Husky West White Rose Project  
EEC A Manufacturing Record Book  
Project Document Number:  
649353-S-A2501-Q09-000003  
Avalon Controls Ref. Number:  
15045-MRB-003**



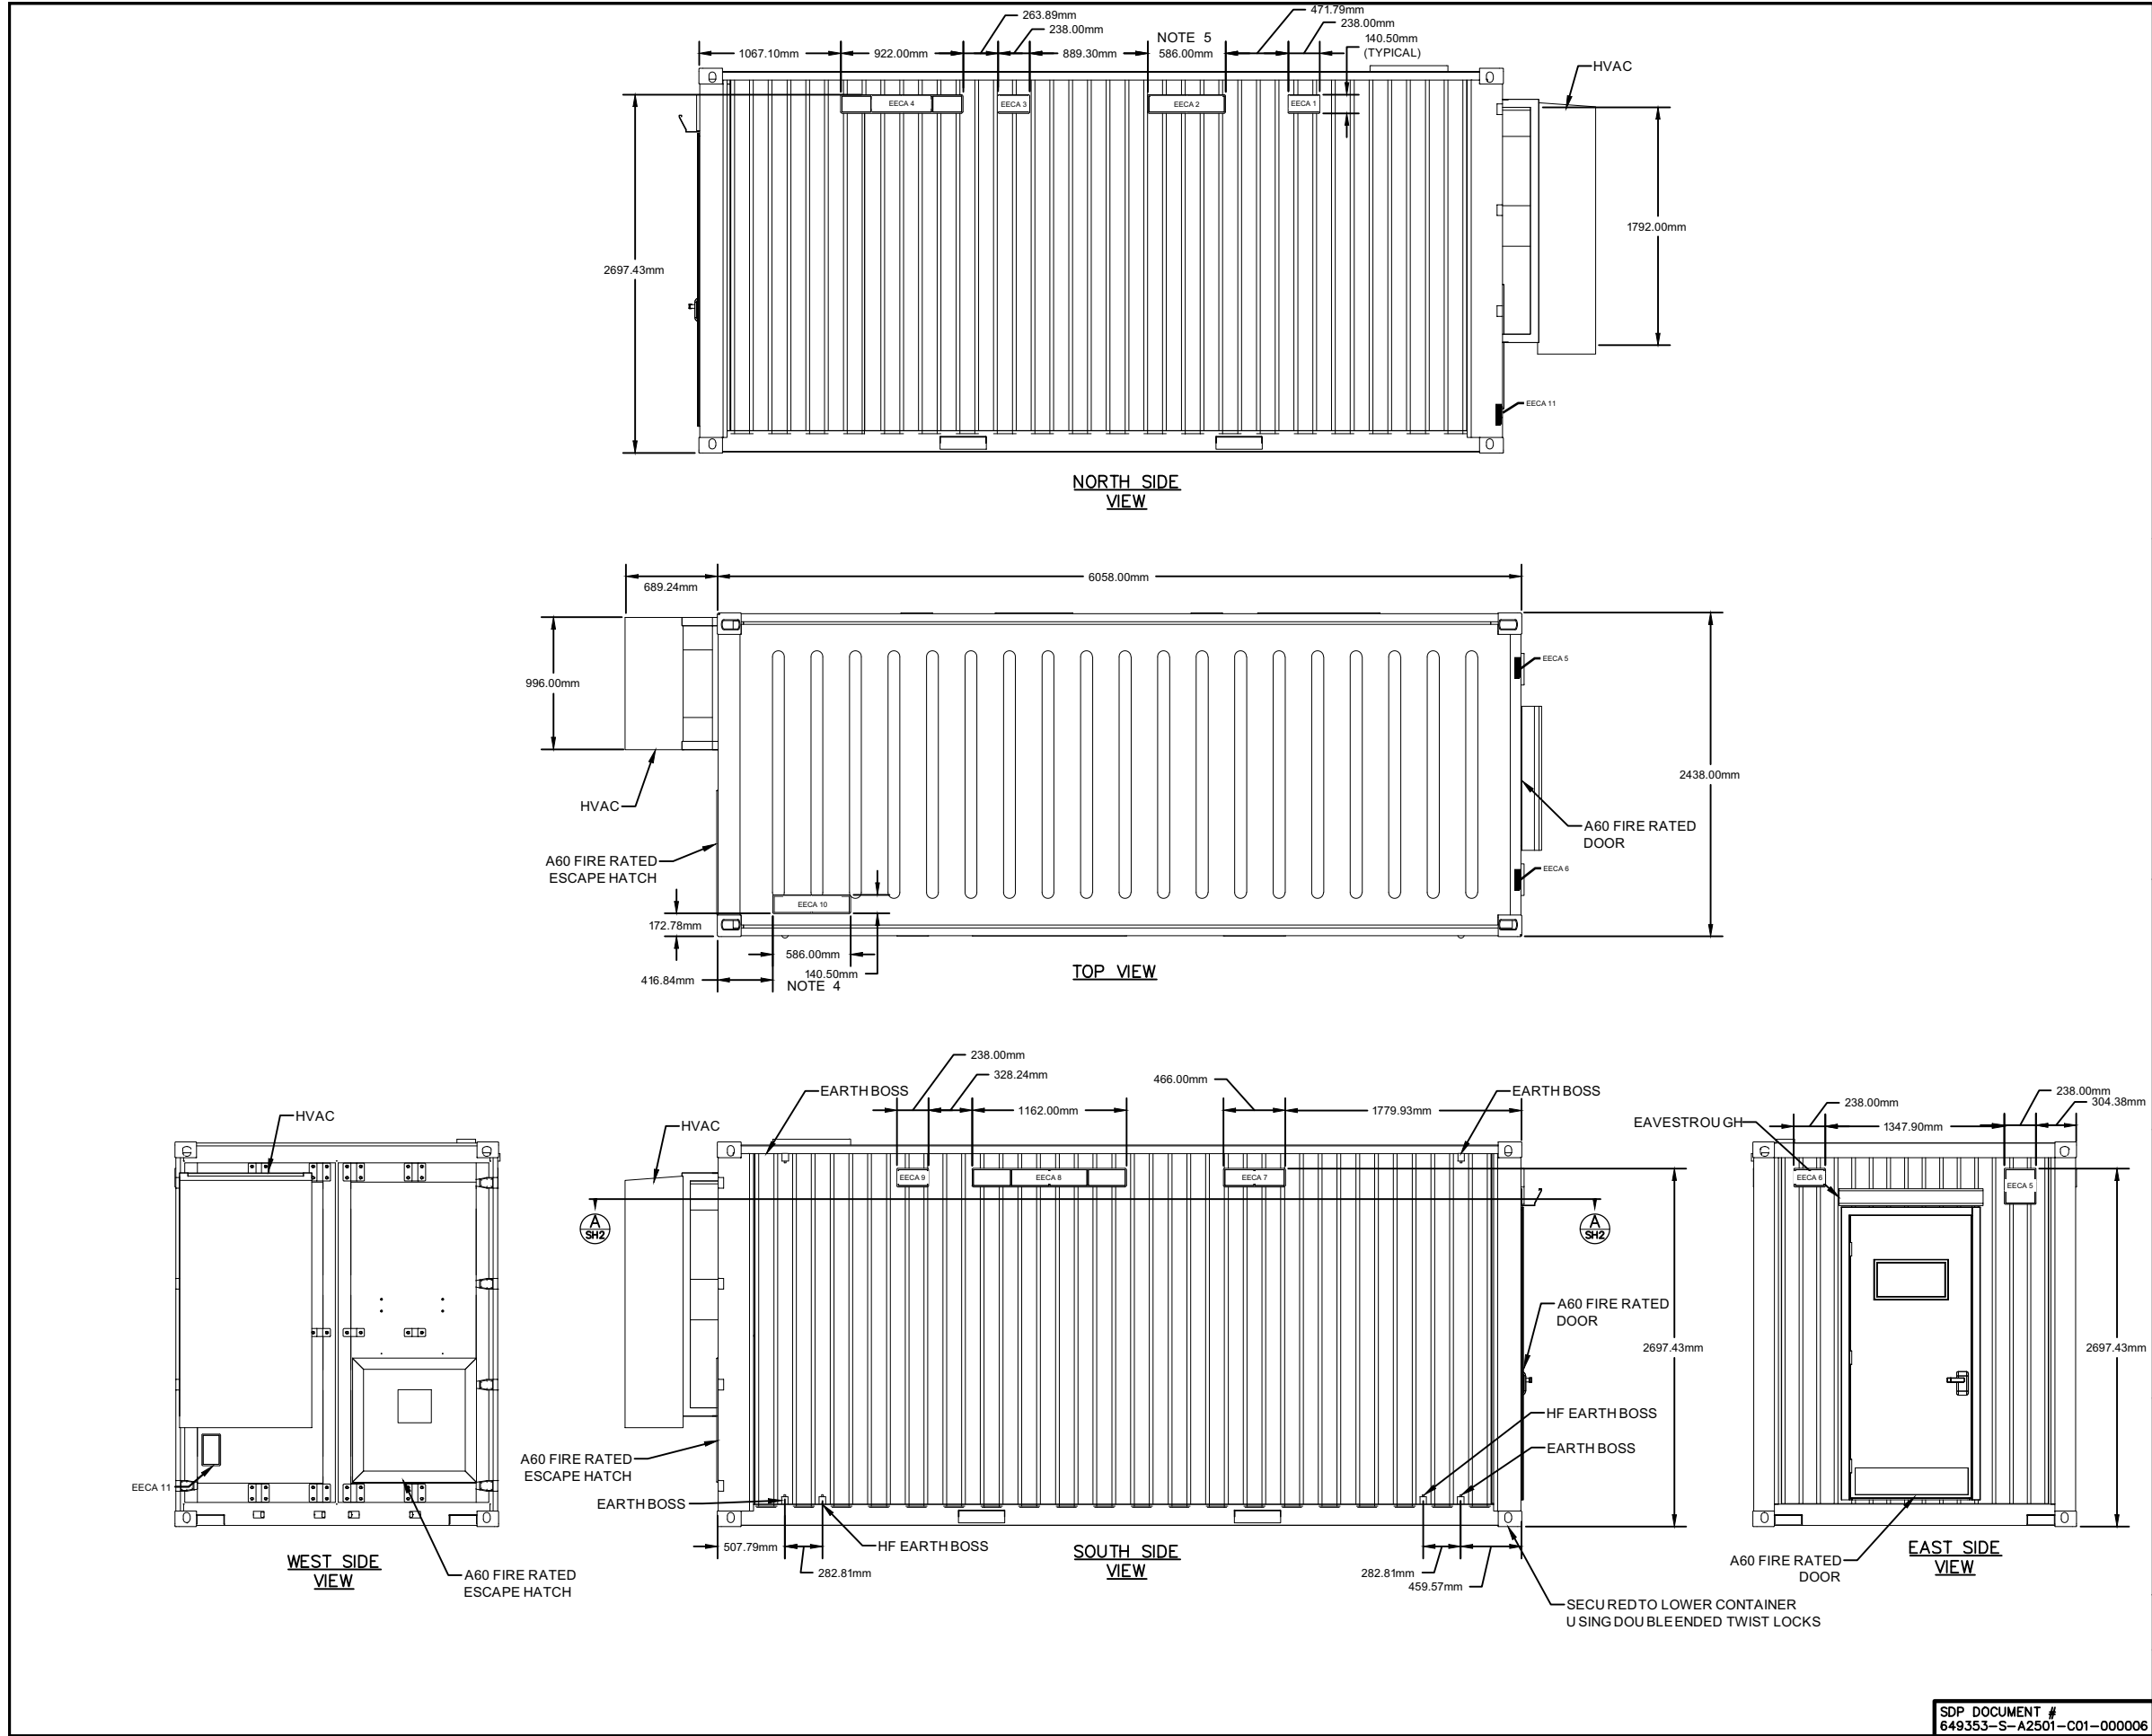

NOTES

- FOR FITTING PURPOSES ONLY. NOT FOR CONSTRUCTION.
- DRAWING SCALE IS APPROXIMATE.
- CONTAINER CONSTRUCTED TO A60 FIRE RATING.
- LOCATION OF CEILING TRANSIT TO ALIGN WITH FLOOR TRANSIT OF BCC CABIN WHEN CONTAINERS ARE STACKED.
- LOCATION OF NORTH SIDE TRANSITS TO ALIGN WITH SOUTH SIDE TRANSITS OF EEC 'B' CABIN WHEN CONTAINERS ARE POSITIONED SIDE BY SIDE.

LEGEND

REVISIONS						
REV	DESCRIPTION	DSG	DRW	CHK	APP	DATE
A00	ISSUED FOR INFORMATION	TJL	LAP	RLF	MAC	APR 07, 2020
B00	ISSUED FOR CONSTRUCTION	RLF	LAP	RLF	MAC	APR 07, 2020
B01	EARTH BOSS AND TRANSIT DETAILS ADDED	RLF	LAP	RLF		
C00	AS BUILT	RLF	LAP	TKH	TKH	FEB 26, 2021

ENGR SEAL

ENGR PERMIT

12 PANTHER PLACE  
MOUNT PEARL, NL, CANADA A1N 5B1  
PH: 709-364-5111  
FAX: 709-364-6616  
WWW.AVALONCONTROLS.CA


NOTICE

THIS DRAWING AND ALL ITS CONTENTS REMAIN THE PHYSICAL AND INTELLECTUAL PROPERTY OF AVALON CONTROLS LTD. AND IT SHALL NOT BE COPIED OR DISTRIBUTED WITHOUT THE CONSENT OF THE COMPANY.

CLIENT	SDP GP WEST WHITE ROSE PROJECT	PROJECT	649353 WEST WHITE ROSE PROJECT S-A2501 ICS AND EDS/ECMS
TITLE ELECTRICAL EQUIPMENT CABIN (EEC) A MECHANICAL GENERAL ARRANGEMENT DIAGRAM			

SCALE	NTS	DWG NO.	15045-11-E-GA-002	SHEET	1 OF 2	REV	C00
-------	-----	---------	-------------------	-------	--------	-----	-----


SDP DOCUMENT #  
649353-S-A2501-C01-000006

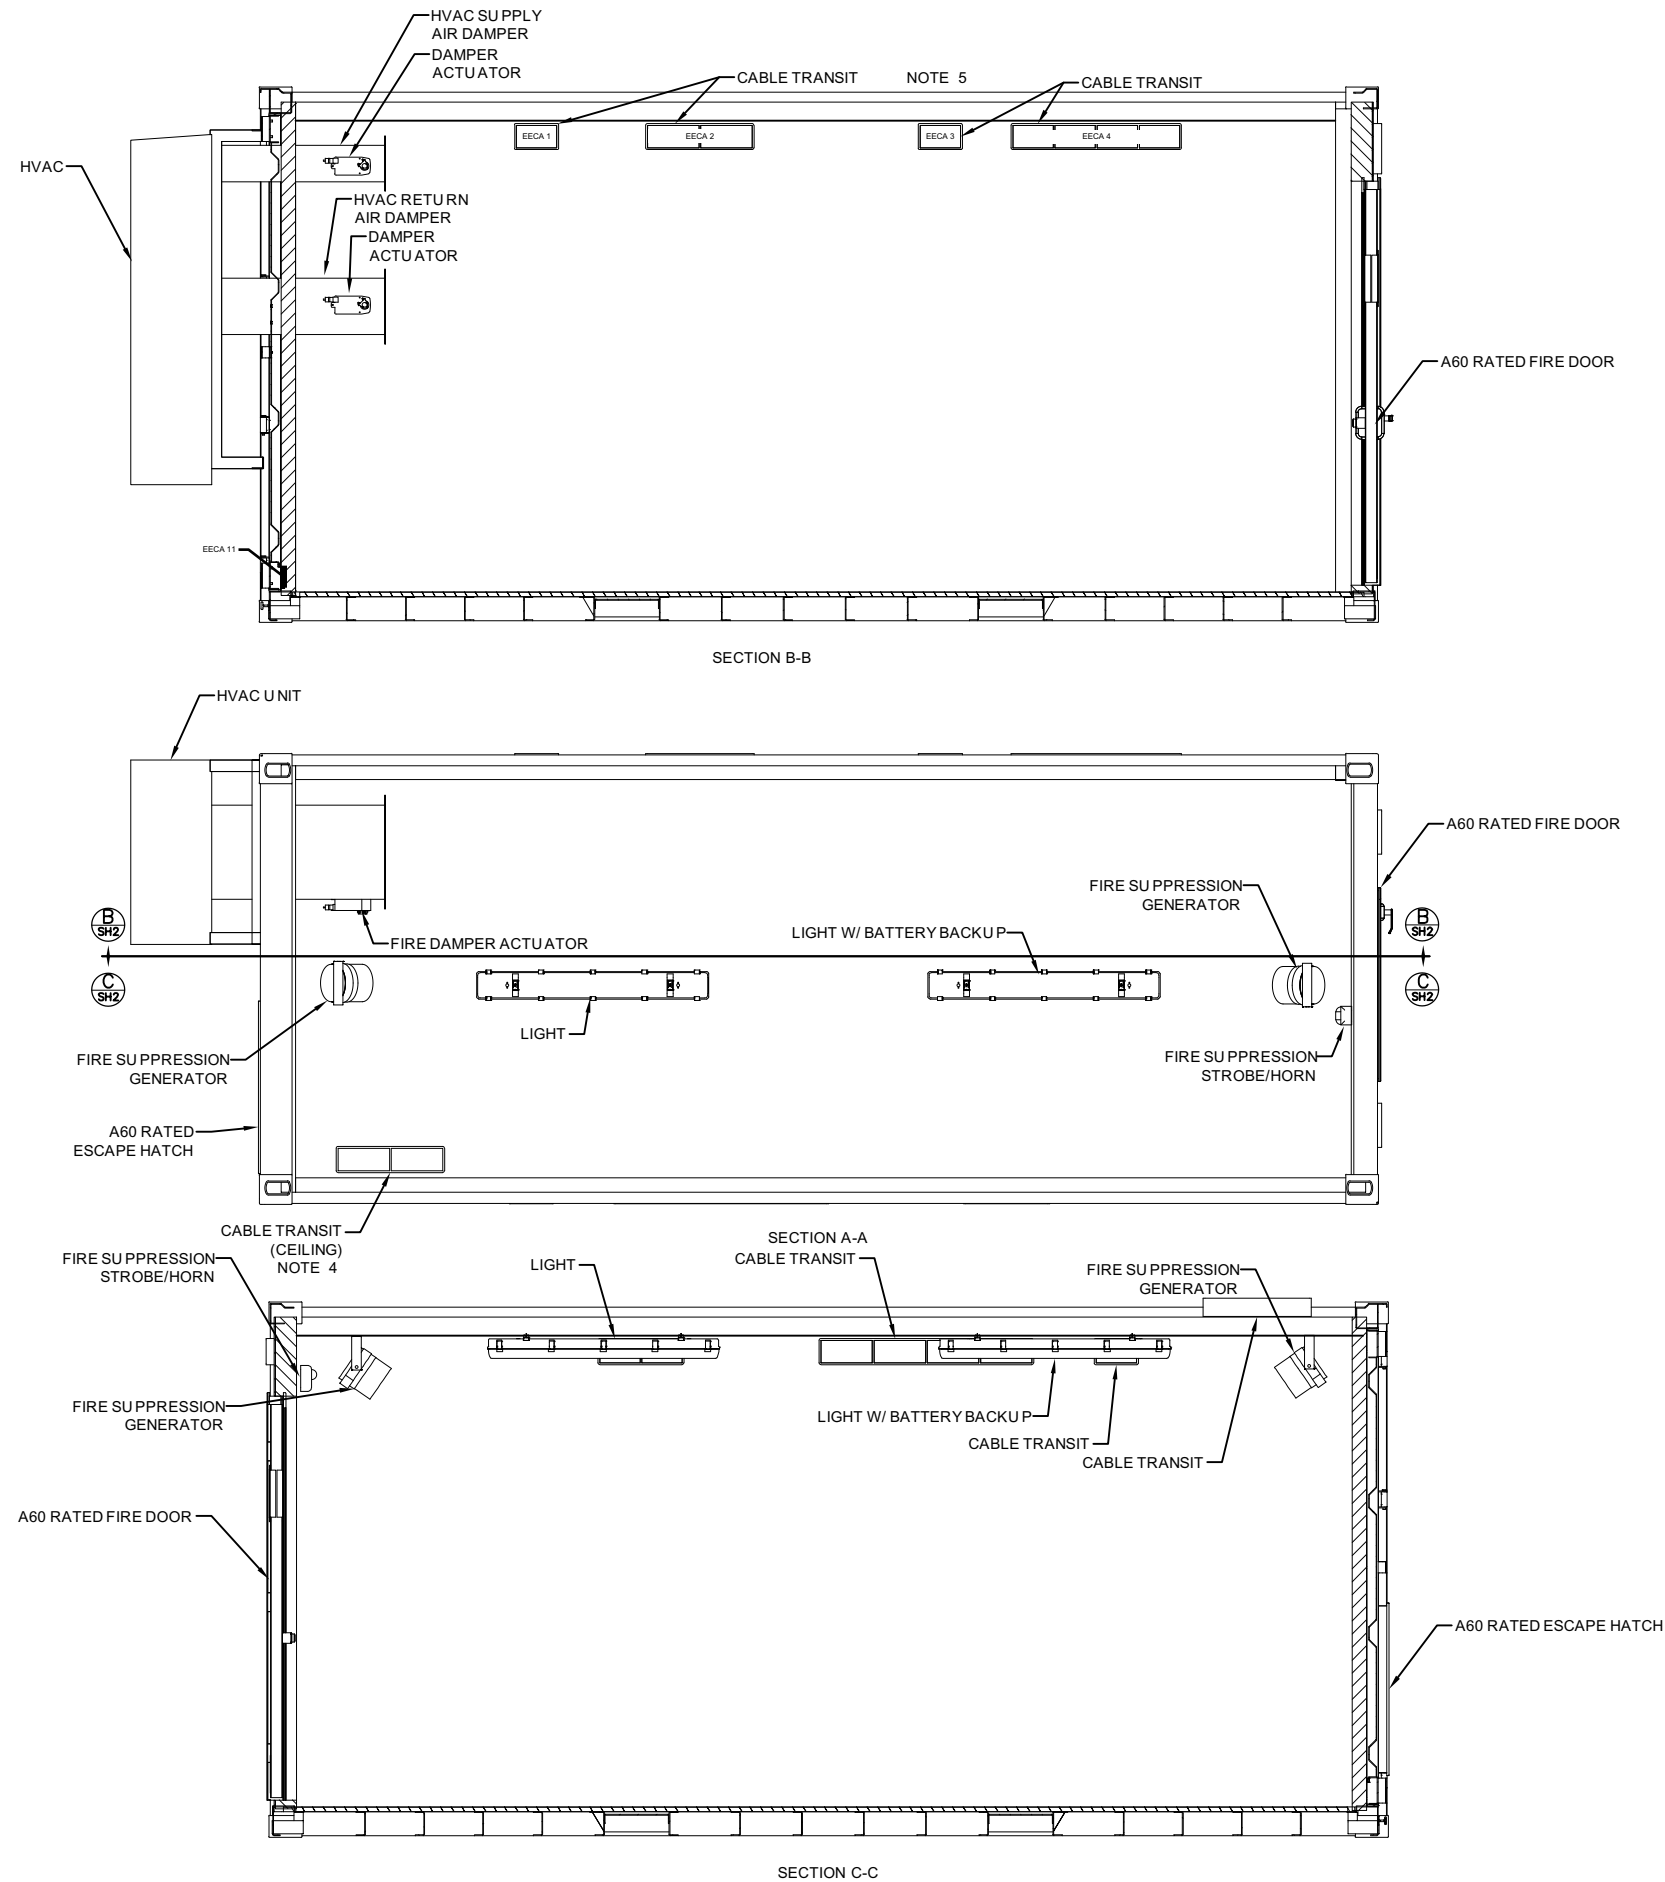

NOTES

1. FOR FITTING PURPOSES ONLY. NOT FOR CONSTRUCTION.
2. DRAWING SCALE IS APPROXIMATE.
3. CONTAINER CONSTRUCTED TO A60 FIRE RATING.
4. LOCATION OF CEILING TRANSIT TO ALIGN WITH FLOOR TRANSIT OF BCC CABIN WHEN CONTAINERS ARE STACKED.
5. LOCATION OF NORTH SIDE TRANSITS TO ALIGN WITH SOUTH SIDE TRANSITS OF EEC 'B' CABIN WHEN CONTAINERS ARE POSITIONED SIDE BY SIDE.

LEGEND

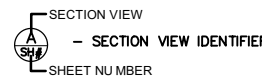

REVISIONS

REV	DESCRIPTION	DSG	DRW	CHK	APP	DATE
A00	ISSUED FOR INFORMATION	TJL	LAP	RLF	MAC	APR 07, 2020
B00	ISSUED FOR CONSTRUCTION	RLF	LAP	RLF	MAC	APR 07, 2020
B01	EARTH BOSS AND TRANSIT DETAILS ADDED	RLF	LAP	RLF		
C00	AS BUILT	RLF	LAP	TKH	TKH	FEB 26, 2021

ENGR SEAL

ENGR PERMIT



12 PANTHER PLACE  
MOUNT PEARL, NL, CANADA A1N 5B1  
PH: 709-364-5111  
FAX: 709-364-6616  
WWW.AVALONCONTROLS.CA

**NOTICE**  
THIS DRAWING AND ALL ITS CONTENTS REMAIN THE PHYSICAL AND INTELLECTUAL PROPERTY OF AVALON CONTROLS LTD. AND IT SHALL NOT BE COPIED OR DISTRIBUTED WITHOUT THE CONSENT OF THE COMPANY.

CLIENT	SDP GP WEST WHITE ROSE PROJECT	PROJECT	649353 WEST WHITE ROSE PROJECT S-A2501 ICS AND EDS/ECMS
--------	--------------------------------------	---------	---

TITLE ELECTRICAL EQUIPMENT CABIN (EEC) A  
MECHANICAL GENERAL ARRANGEMENT DIAGRAM

SCALE	NTS	DWG NO.	15045-11-E-GA-002	SHEET	2	OF	2	REV	C00
-------	-----	---------	-------------------	-------	---	----	---	-----	-----

ALL PRINTED COPIES OF THIS DRAWING ARE CONSIDERED UNCONTROLLED