


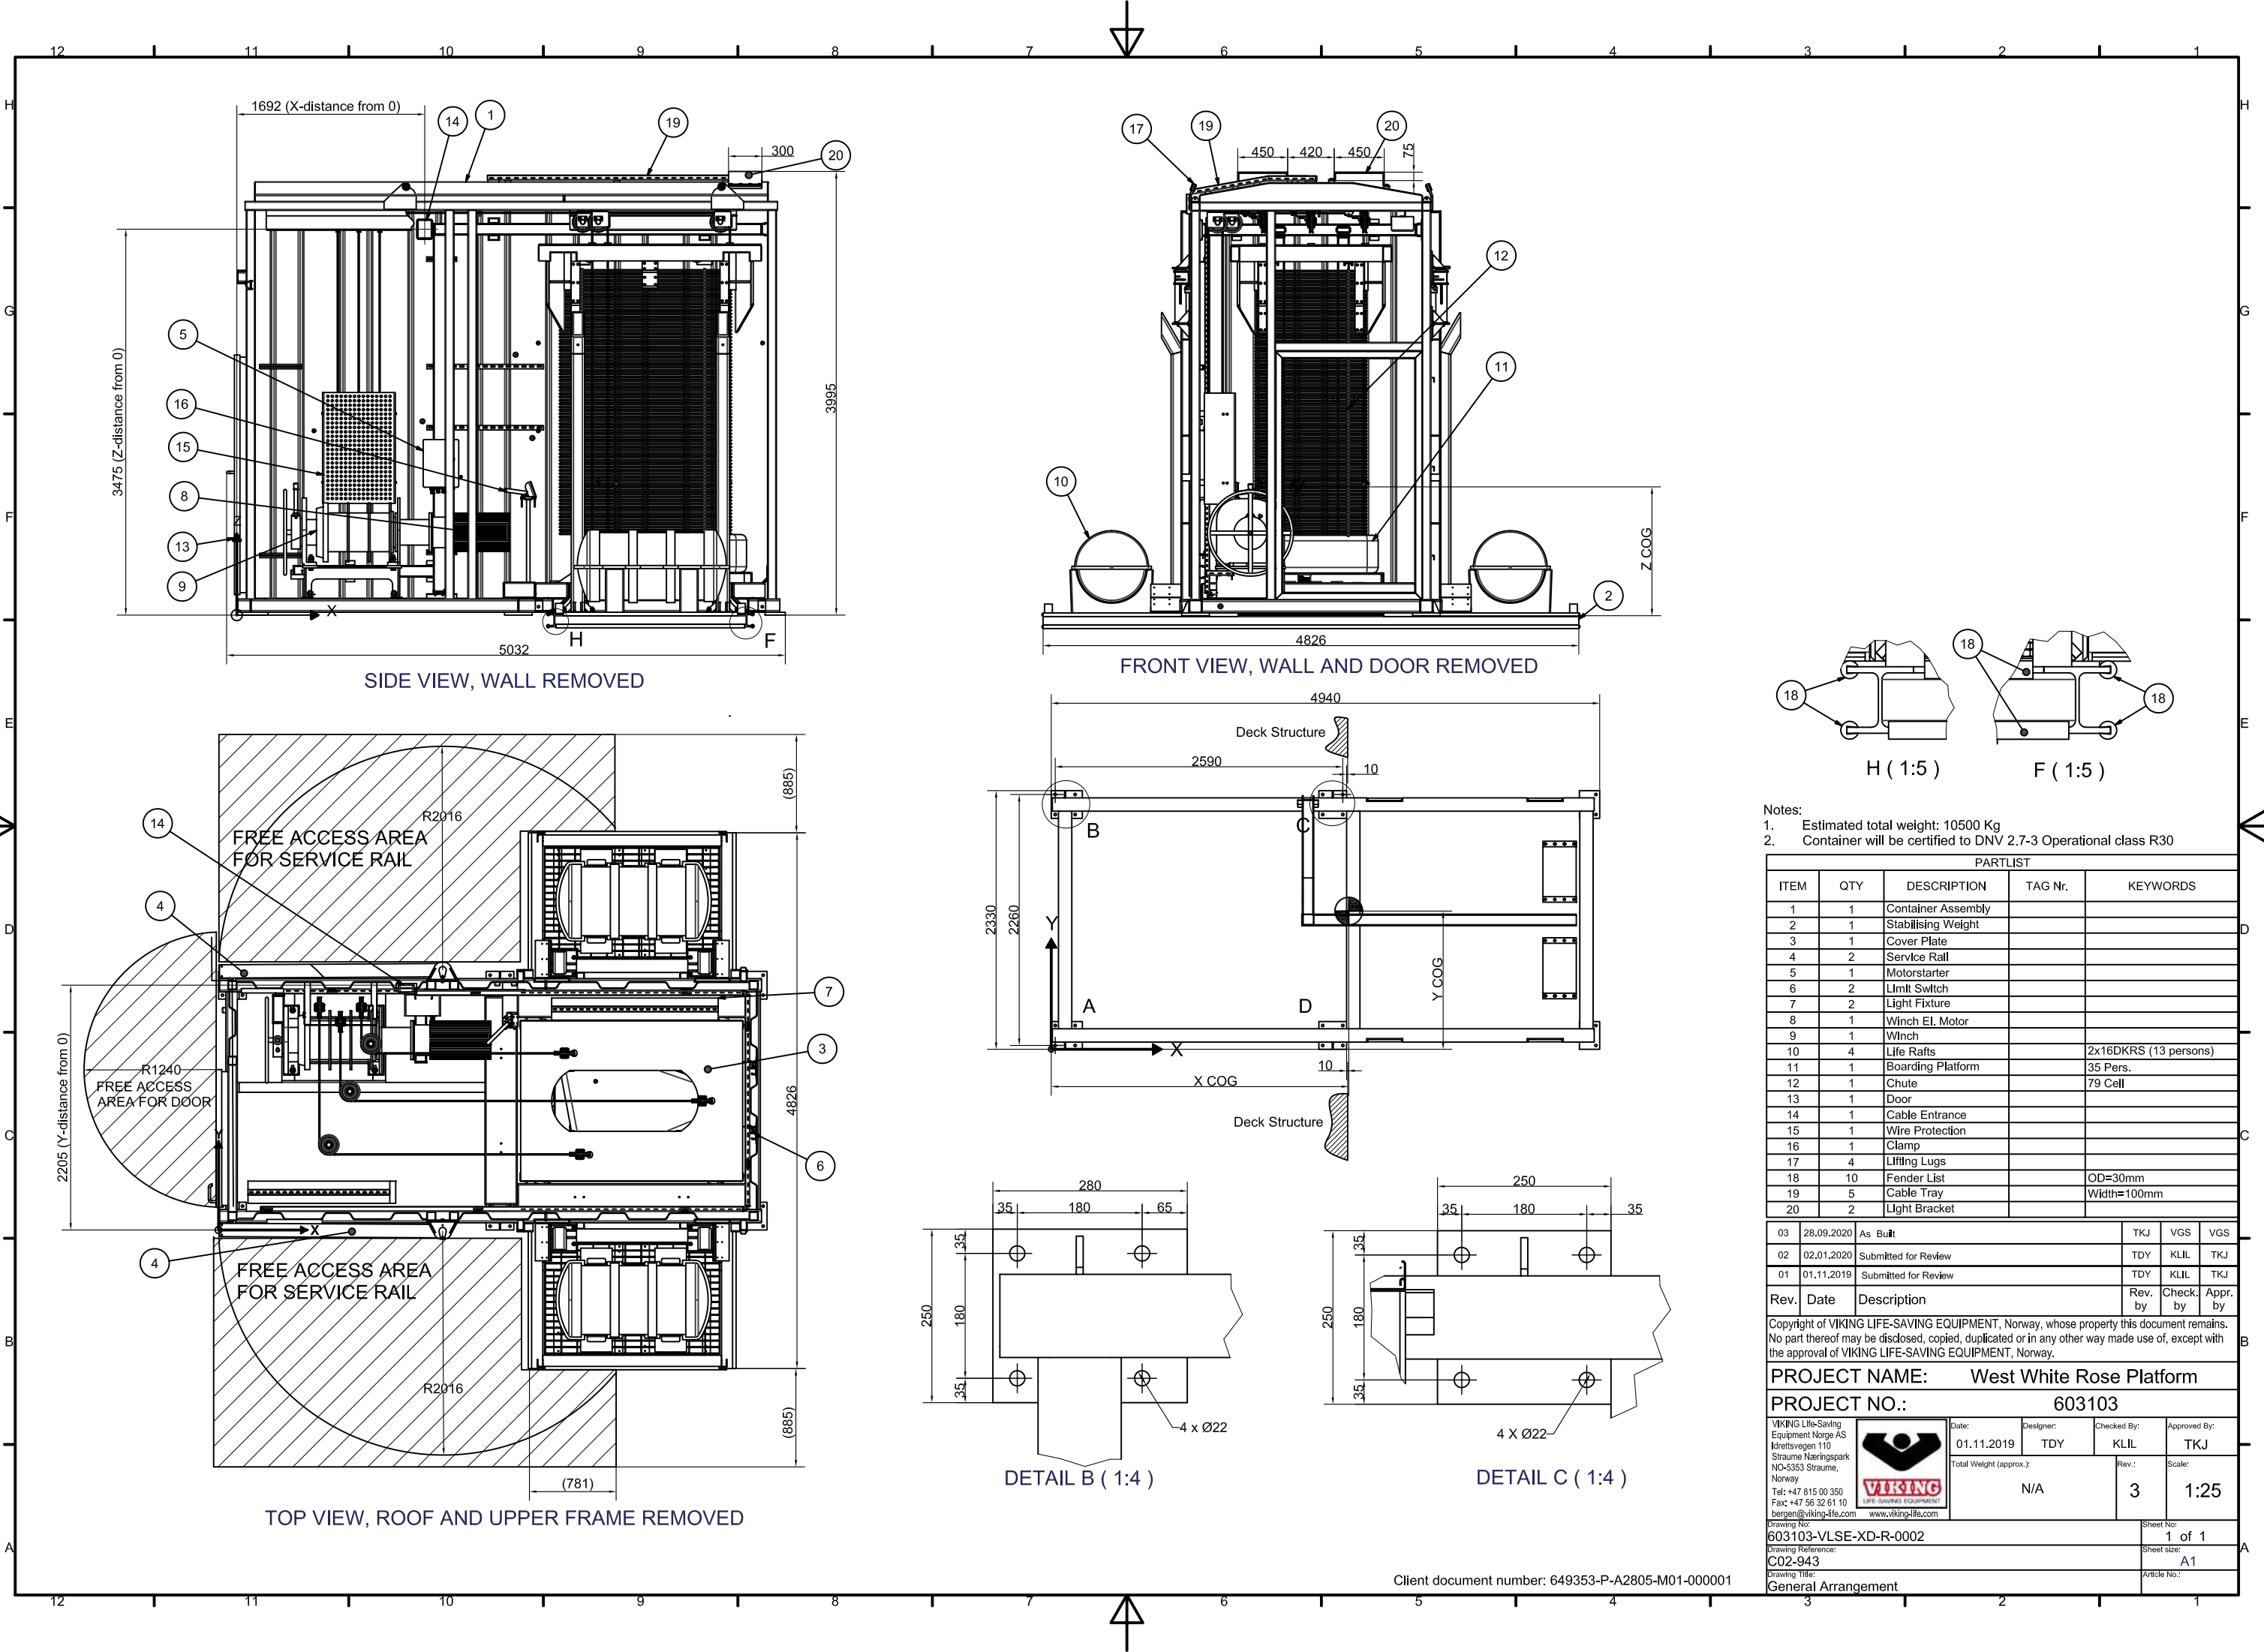

Notes:

1. Estimated total weight: 10500 Kg

2. Container will be certified to DNV 2.7-3 Operational class R30

PARTLIST				
ITEM	QTY	DESCRIPTION	TAG Nr.	KEYWORDS
1	1	Container Assembly		
2	1	Stabilising Weight		
3	1	Cover Plate		
4	2	Service Rail		
5	1	Motorstarter		
6	2	Limit Switch		
7	2	Light Fixture		
8	1	Winch El. Motor		
9	1	Winch		
10	4	Life Rafts		2x16DKRS (13 persons)
11	1	Boarding Platform		35 Pers.
12	1	Chute		79 Cell
13	1	Door		
14	1	Cable Entrance		
15	1	Wire Protection		
16	1	Clamp		
17	4	Lifting Lugs		
18	10	Fender List		OD=30mm
19	5	Cable Tray		Width=100mm
20	2	Light Bracket		

03	28.09.2020	As Built	TKJ	VGS	VGS
02	02.01.2020	Submitted for Review	TDY	KLIL	TKJ
01	01.11.2019	Submitted for Review	TDY	KLIL	TKJ
Rev.	Date	Description	Rev. by	Check. by	Appr. by

Copyright of VIKING LIFE-SAVING EQUIPMENT, Norway, whose property this document remains. No part thereof may be disclosed, copied, duplicated or in any other way made use of, except with the approval of VIKING LIFE-SAVING EQUIPMENT, Norway.

PROJECT NAME: West White Rose Platform

PROJECT NO.: 603103

VIKING Life-Saving Equipment Norge AS Idrettsvegen 110 Straume Næringspark NO-5353 Straume, Norway Tel: +47 815 00 350 Fax: +47 55 32 61 10 bergen@viking-life.com www.viking-life.com		Date: 01.11.2019	Designer: TDY	Checked By: KLIL	Approved By: TKJ
Total Weight (approx.): N/A		Rev.:	3	Scale: 1:25	

Drawing No: 603103-VLSE-XD-R-0002

Drawing Reference: C02-943

Drawing Title: General Arrangement

Sheet No: 1 of 1

Sheet size: A1

Article No.: