


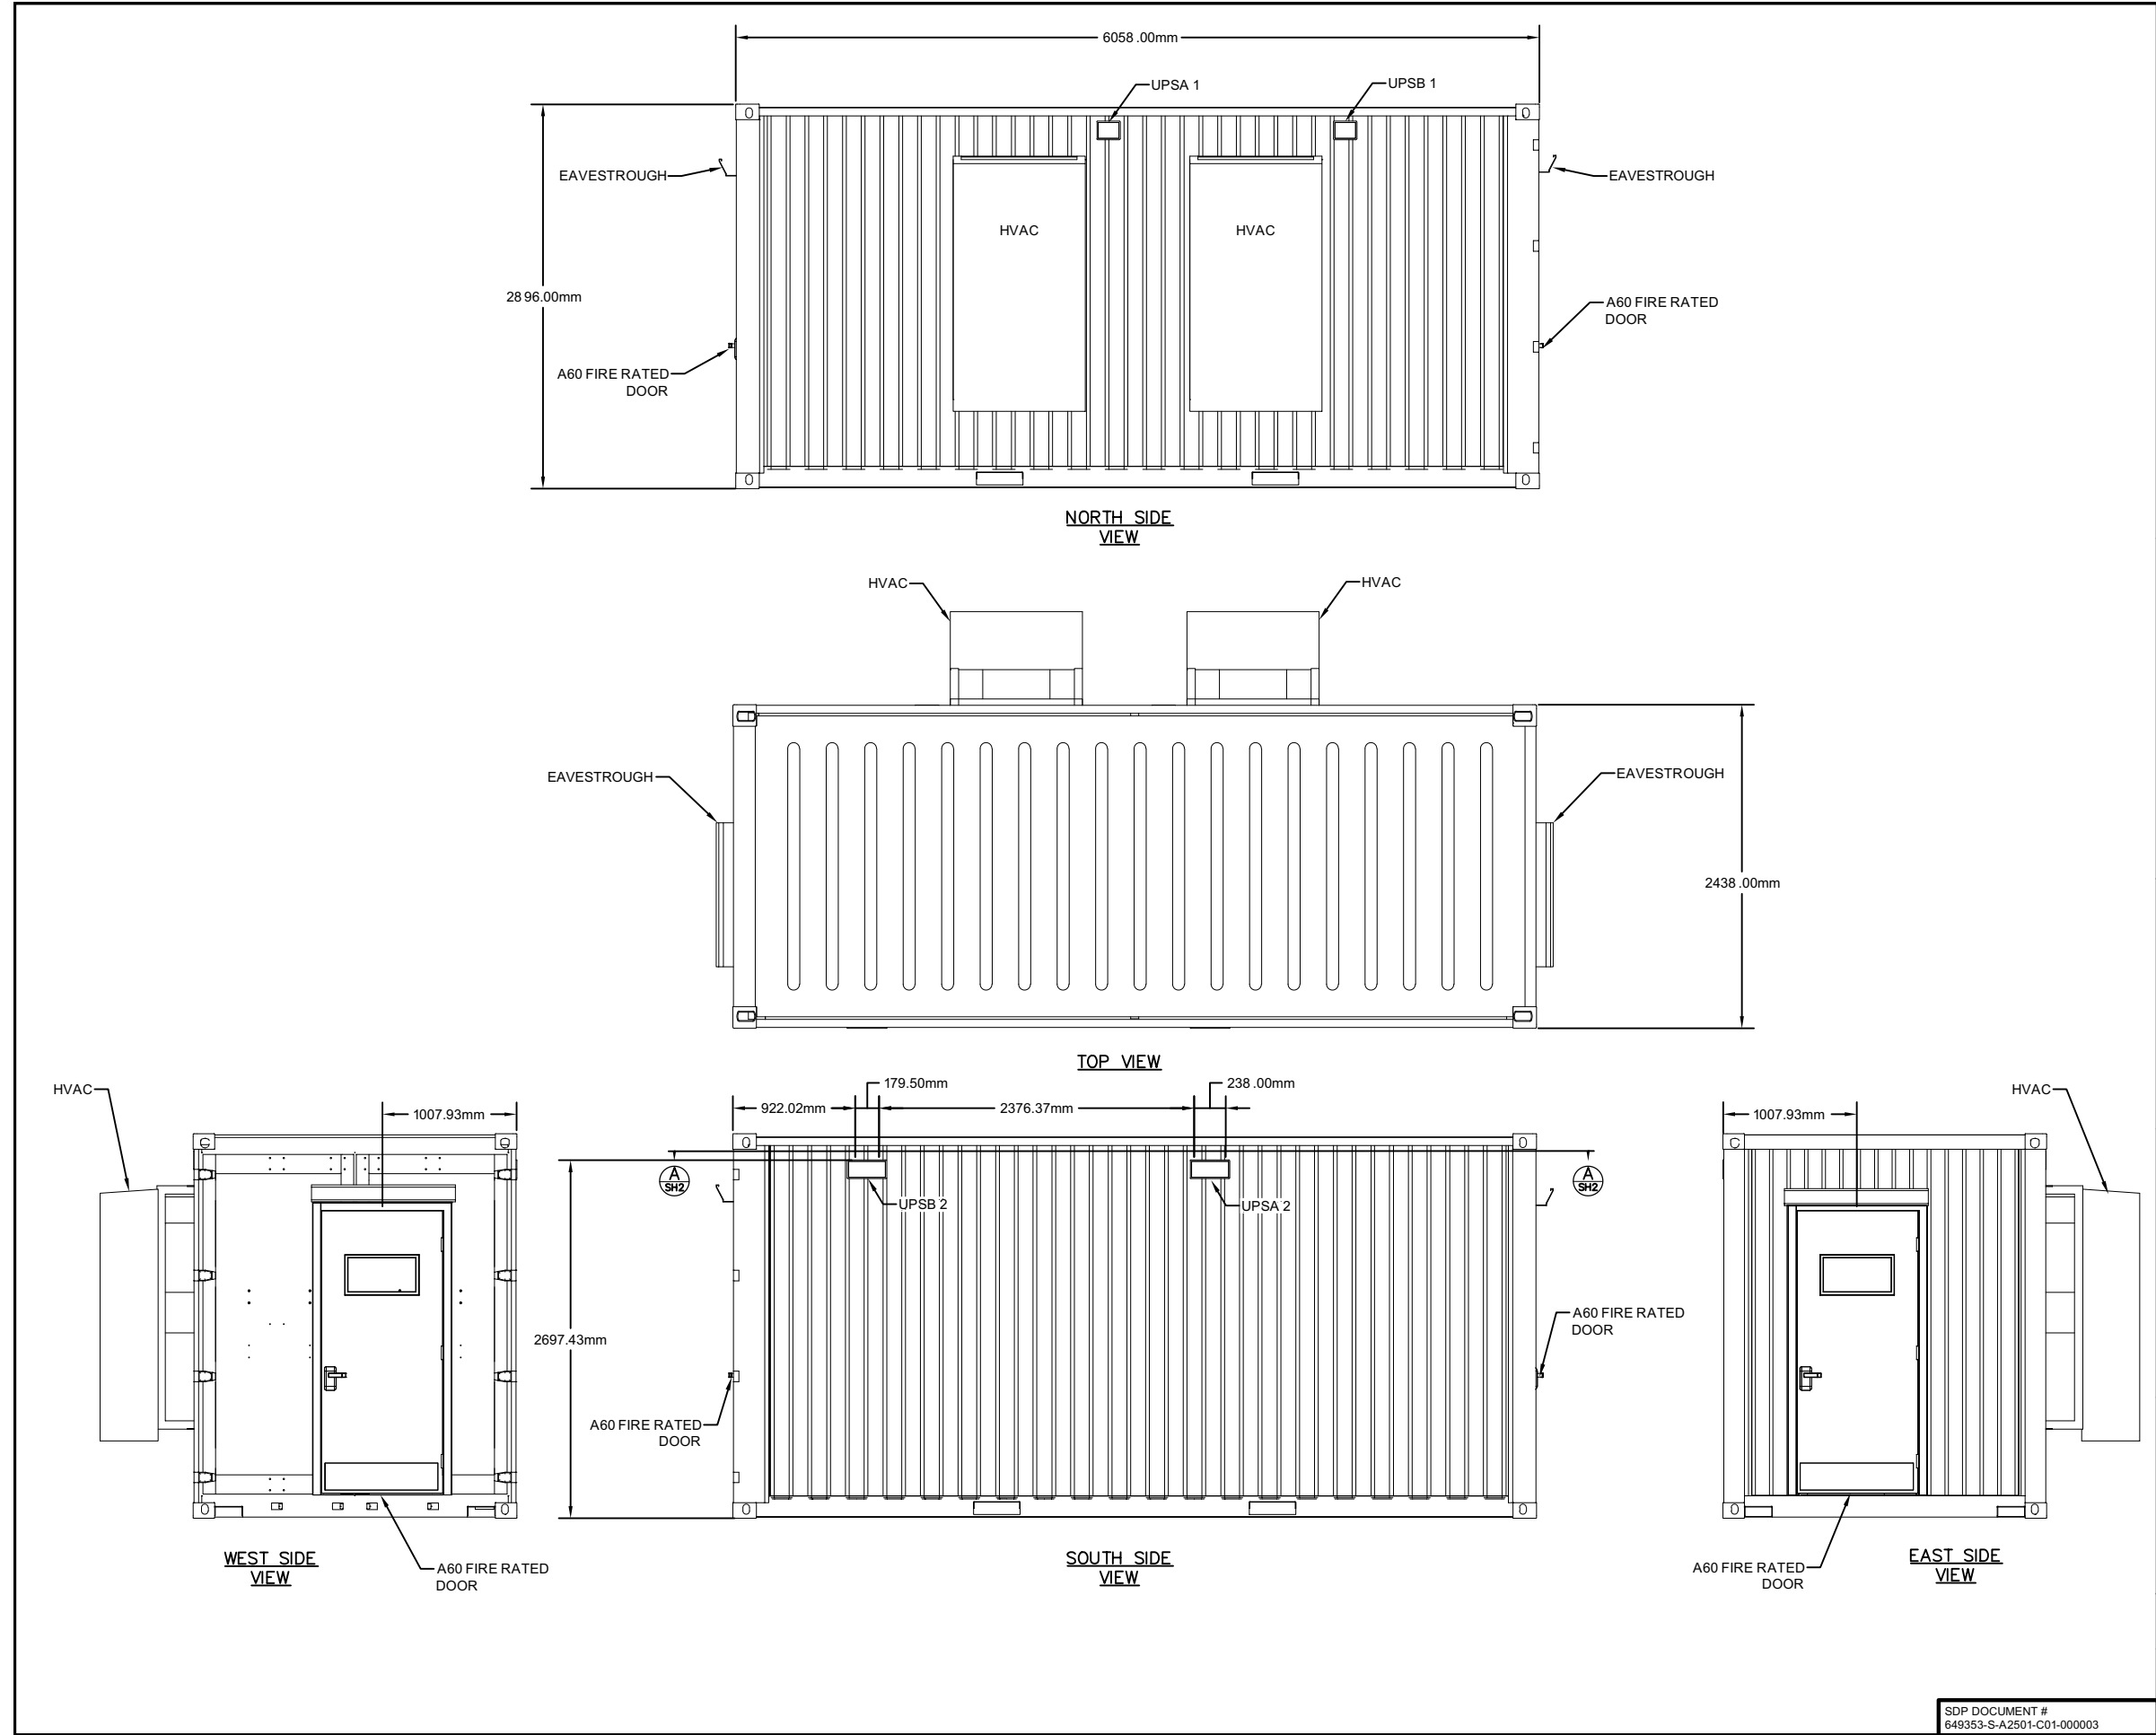

NOTES

1. DRAWING SCALE IS APPROXIMATE.
2. CONTAINER CONSTRUCTED TO A60 FIRE RATING.

LEGEND

SECTION VIEW
- SECTION VIEW IDENTIFIER
SHEET NUMBER

REVISIONS

REV	DESCRIPTION	DSG	DRW	CHK	APP	DATE
A00	INITIAL DESIGN	TJL	LAP	KAP		
A01	INITIAL DESIGN	TJL	LAP	KAP		
A02	ISSUED FOR FITTING	RLF	LAP	RLF	MAC	MAY 05, 2019
B00	ISSUED FOR CONSTRUCTION	LAP	LAP			
C00	AS BUILT	LAP	LAP	TKH	TKH	MAR 17, 2021

ENGR SEAL

ENGR PERMIT

AVALON

12 PANTHER PLACE
MOUNT PEARL, NL, CANADA A1N 5B1
PH: 709-364-5111
FAX: 709-364-6616
WWW.AVALONCONTROLS.CA

NOTICE

THIS DRAWING AND ALL ITS CONTENTS REMAIN THE PHYSICAL AND INTELLECTUAL PROPERTY OF AVALON CONTROLS LTD. AND IT SHALL NOT BE COPIED OR DISTRIBUTED WITHOUT THE CONSENT OF THE COMPANY.




CLIENTSDP GP
WEST WHITE ROSE
PROJECT

PROJECT628768 P A2735
POWER DISTRIBUTION SYSTEM

TITLE

120/208V UPS CABIN
GENERAL ARRANGEMENT DIAGRAM


SCALE	NTS	DWG NO.	15045-13-E-GA-001	SHEET	1 OF 2	REV	C00
-------	-----	---------	-------------------	-------	--------	-----	-----

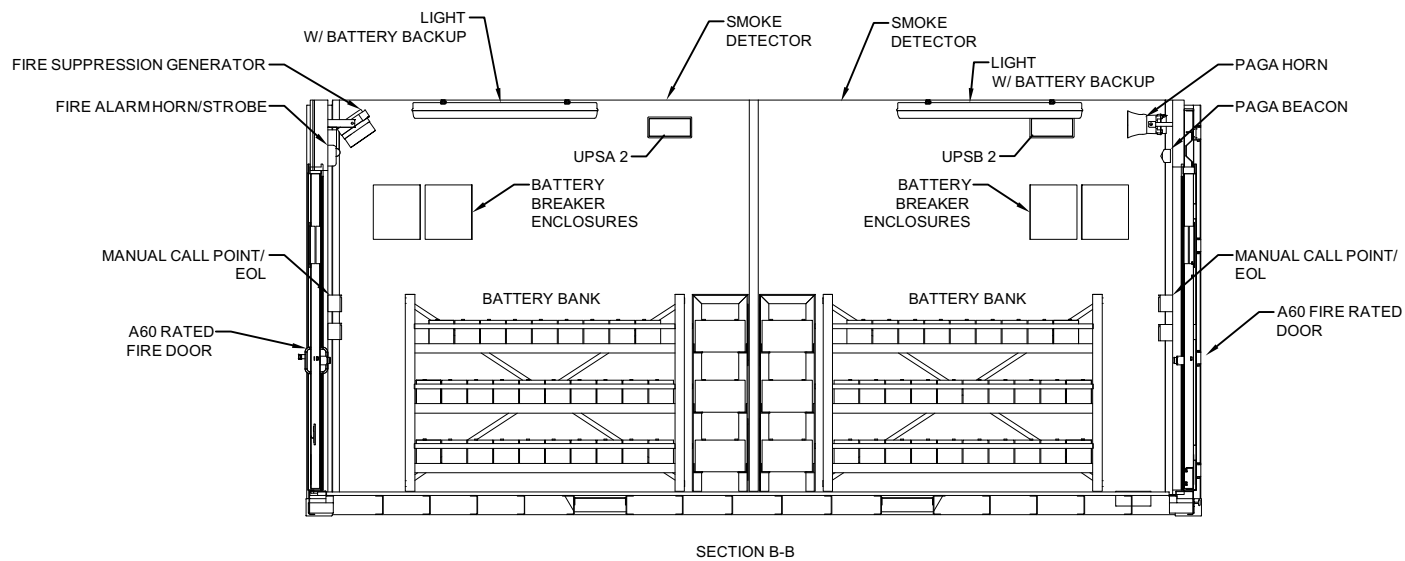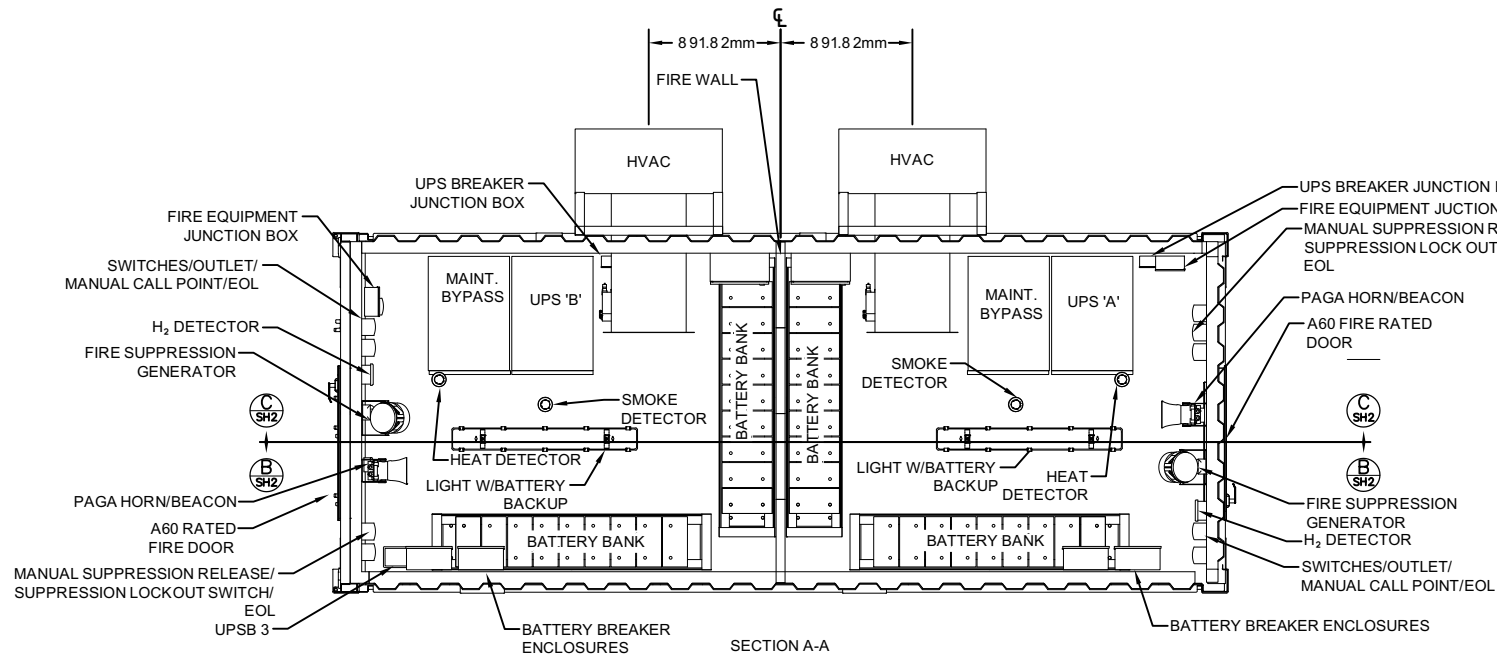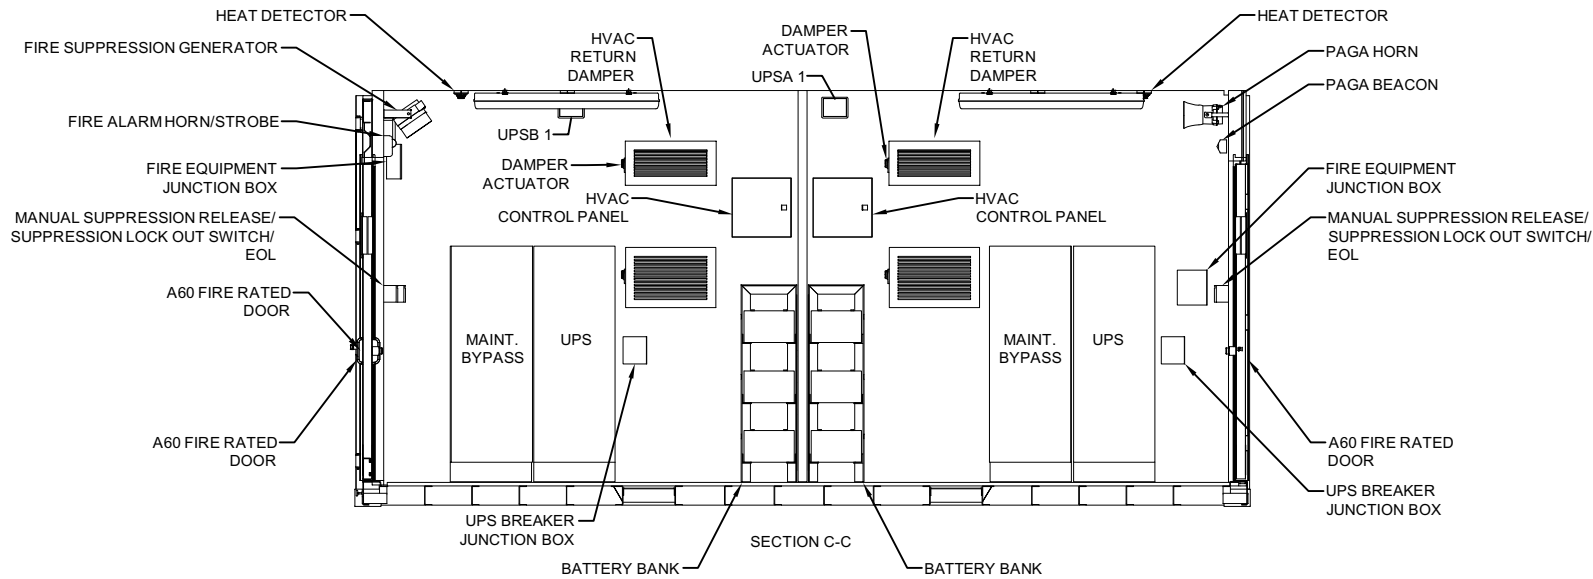

NOTES

1. DRAWING SCALE IS APPROXIMATE.
2. CONTAINER CONSTRUCTED TO A60 FIRE RATING.

LEGEND

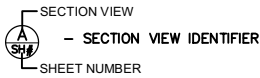

REVISIONS

REV	DESCRIPTION	DSG	DRW	CHK	APP	DATE
A00	INITIAL DESIGN	TJL	LAP	KAP		
A01	INITIAL DESIGN	TJL	LAP	KAP		
A02	ISSUED FOR REVIEW	RLF	LAP	RLF	MAC	MAY 05, 2019
B00	ISSUED FOR CONSTRUCTION	LAP	LAP			
C00	AS BUILT	LAP	LAP	TKH	TKH	MAR 16, 2021

ENGR SEAL

ENGR PERMIT



12 PANTHER PLACE
MOUNT PEARL, NL, CANADA A1N 5B1
PH: 709-364-5111
FAX: 709-364-6616
WWW.AVALONCONTROLS.CA


NOTICE
THIS DRAWING AND ALL ITS
CONTENTS REMAIN THE
PHYSICAL AND
INTELLECTUAL PROPERTY OF
AVALON CONTROLS LTD.
AND IT SHALL NOT BE
COPIED OR DISTRIBUTED
WITHOUT THE CONSENT OF
THE COMPANY.

CLIENT	SDP GP WEST WHITE ROSE PROJECT	PROJECT	628768 P A2735 POWER DISTRIBUTION SYSTEM
--------	--------------------------------------	---------	---

TITLE	120/208V UPS CABIN GENERAL ARRANGEMENT DIAGRAM
-------	---

SCALE	NTS	DWG NO.	15045-13-E-GA-001	SHEET	2 OF 2	REV	C00
-------	-----	---------	-------------------	-------	--------	-----	-----

ALL PRINTED COPIES OF THIS DRAWING ARE CONSIDERED UNCONTROLLED

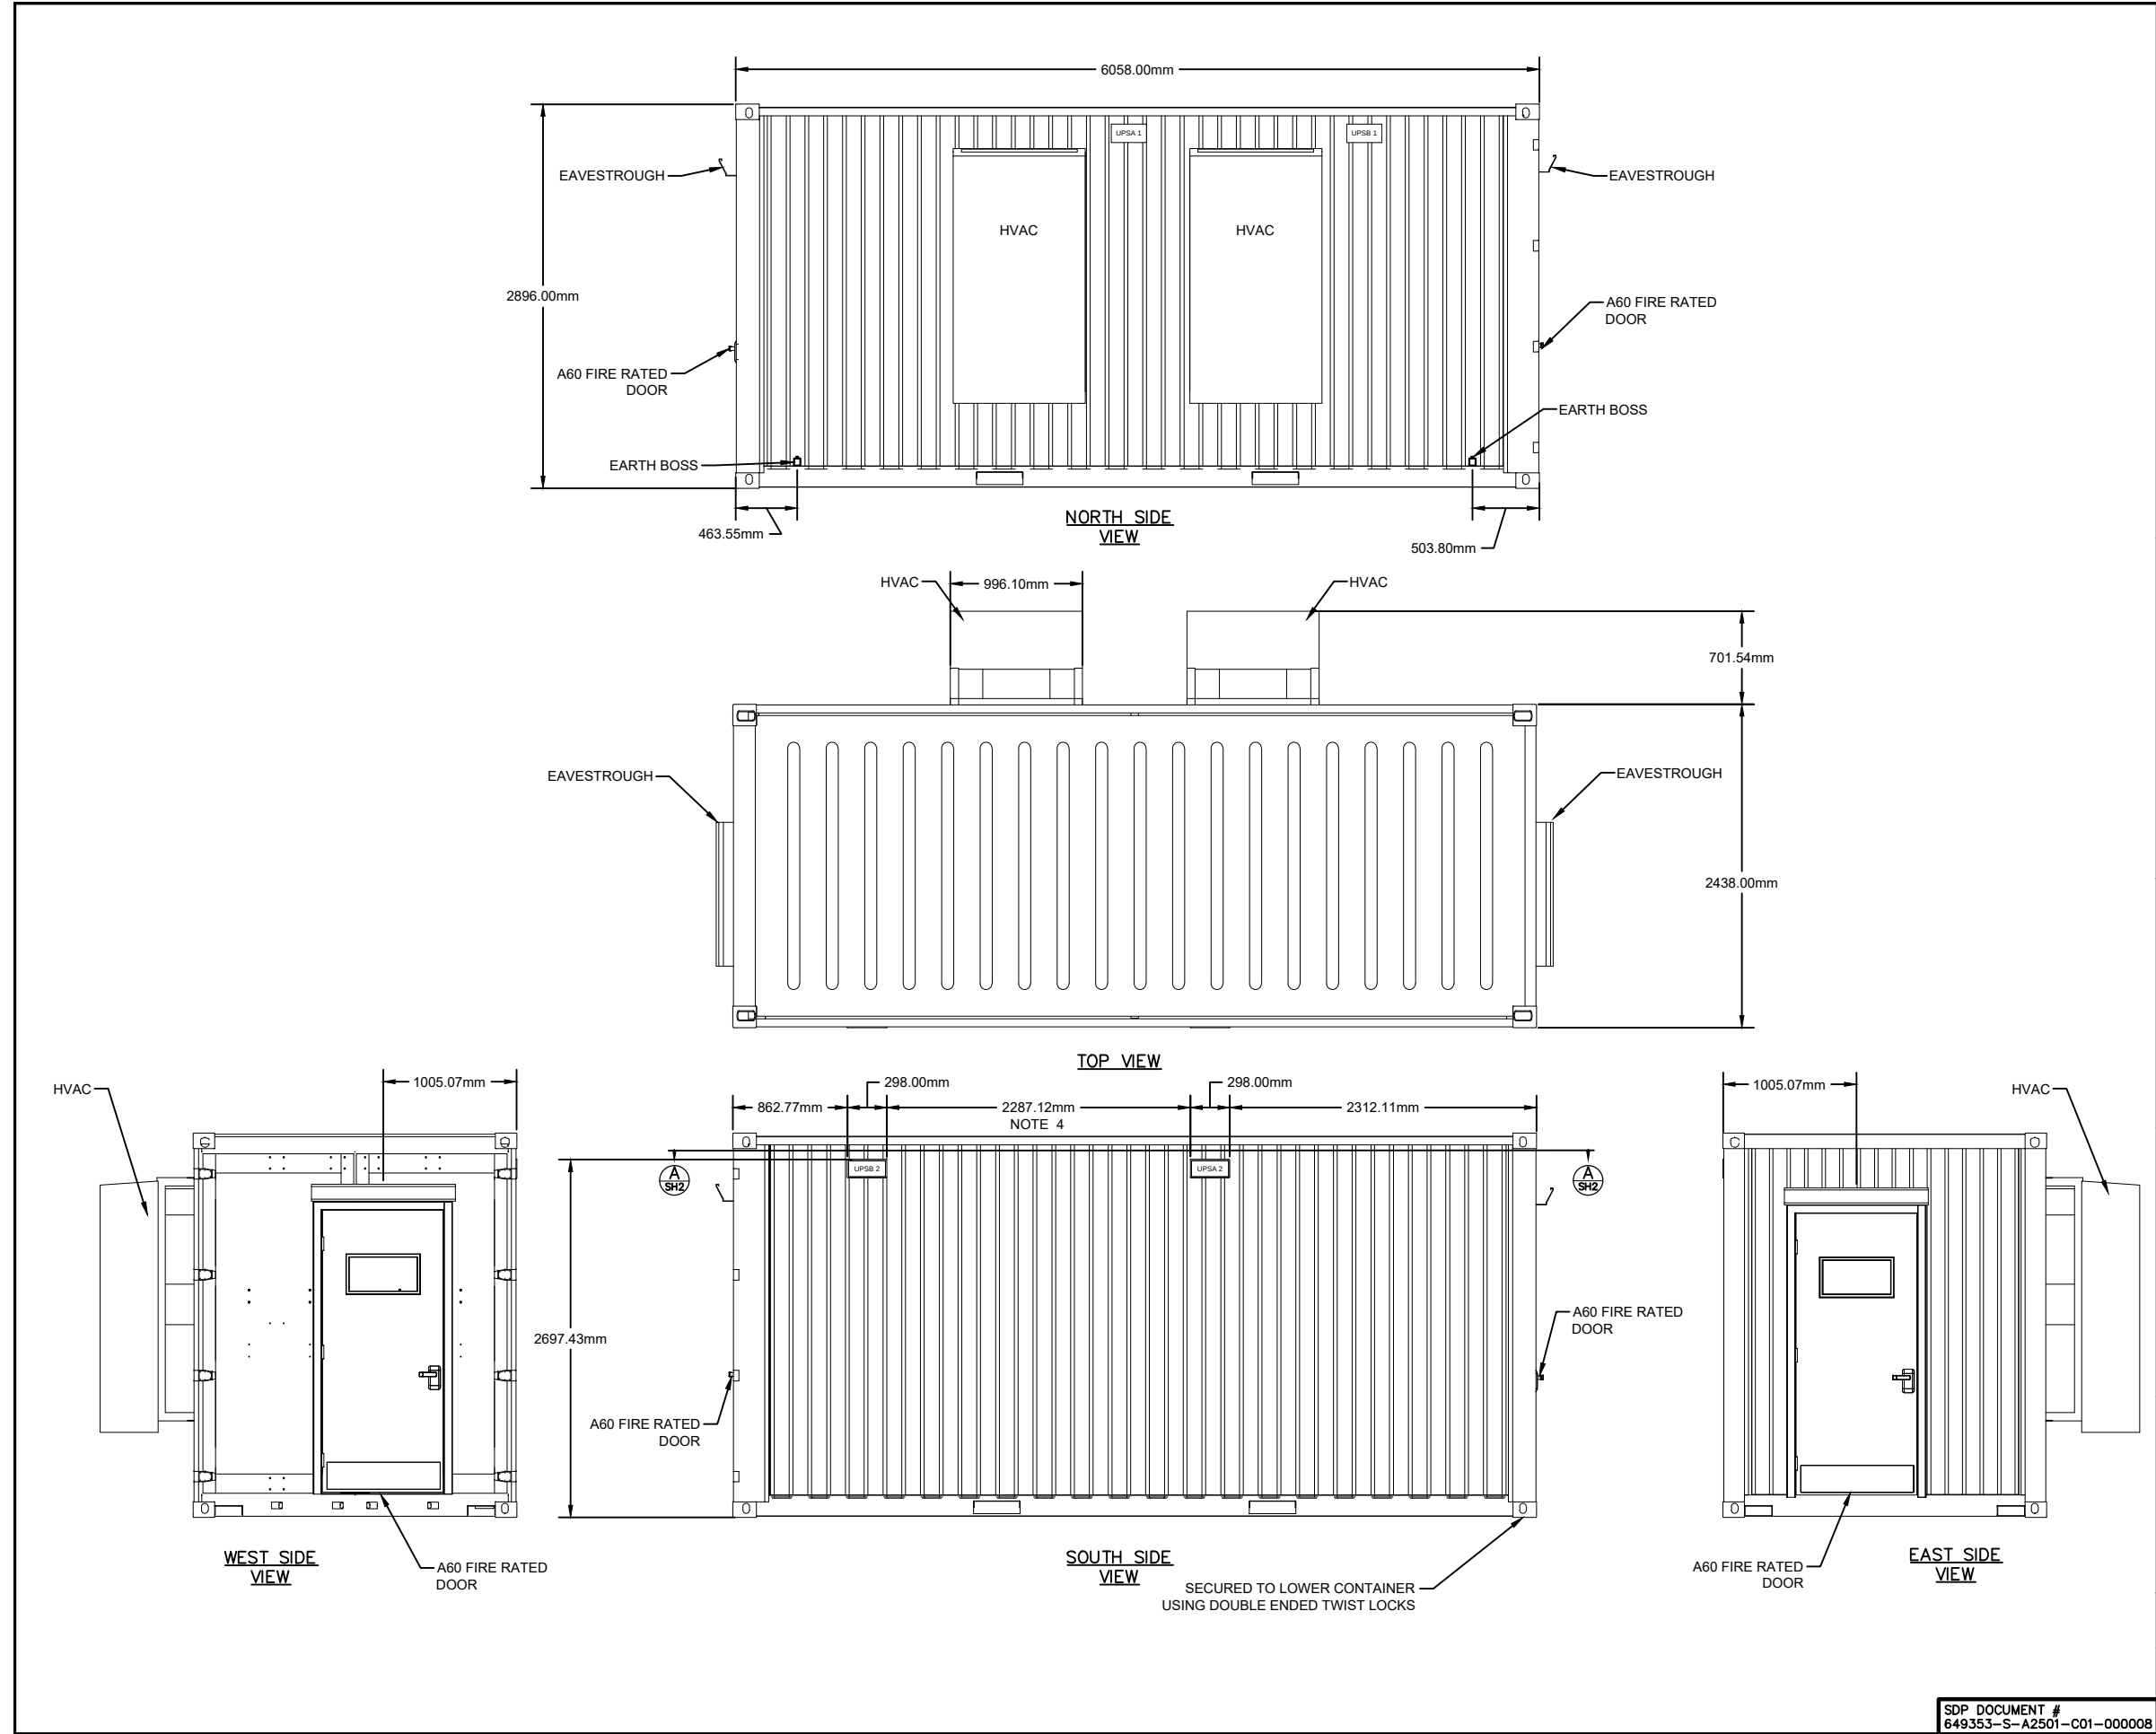

NOTES

- FOR FITTING PURPOSES ONLY. NOT FOR CONSTRUCTION.
- DRAWING SCALE IS APPROXIMATE.
- CONTAINER CONSTRUCTED TO A60 FIRE RATING.
- SOUTH SIDE TRANSITS TO ALIGN WITH BCC NORTH SIDE TRANSITS WHEN CONTAINERS ARE POSITIONED SIDE BY SIDE.

LEGEND

SECTION VIEW
- SECTION VIEW IDENTIFIER
SHEET NUMBER

REVISIONS

REV	DESCRIPTION	DSG	DRW	CHK	APP	DATE
A00	ISSUED FOR INFORMATION	TJL	LAP	KAP	MAC	APR 07, 2020
B00	ISSUED FOR CONSTRUCTION	RLF	LAP	RLF	MAC	APR 07, 2020
B01	EARTH BOSS AND TRANSIT DETAILS ADDED	RLF	LAP	RLF		
C00	AS BUILT	RLF	LAP	TKH	TKH	FEB 26, 2021
C01	REVISED AS BUILT	RLF	LAP	TKH	TKH	AUG 02, 2021

ENGR SEAL

ENGR PERMIT

AVALON

12 PANTHER PLACE
MOUNT PEARL, NL, CANADA A1N 5B1
PH: 709-364-5111
FAX: 709-364-6616
WWW.AVALONCONTROLS.CA

NOTICE

THIS DRAWING AND ALL ITS CONTENTS REMAIN THE PHYSICAL AND INTELLECTUAL PROPERTY OF AVALON CONTROLS LTD. AND IT SHALL NOT BE COPIED OR DISTRIBUTED WITHOUT THE CONSENT OF THE COMPANY.

CLIENTSDP GP
WEST WHITE ROSE
PROJECT


PROJECT628768 P A2735
POWER DISTRIBUTION SYSTEM

TITLE120/208V UPS CABIN
MECHANICAL GENERAL ARRANGEMENT DIAGRAM


SDP DOCUMENT #
649353-S-A2501-C01-000008

SCALENTSDWG NO. 15045-13-E-GA-002SHEET 1 OF 2REV C00


ALL PRINTED COPIES OF THIS DRAWING ARE CONSIDERED UNCONTROLLED

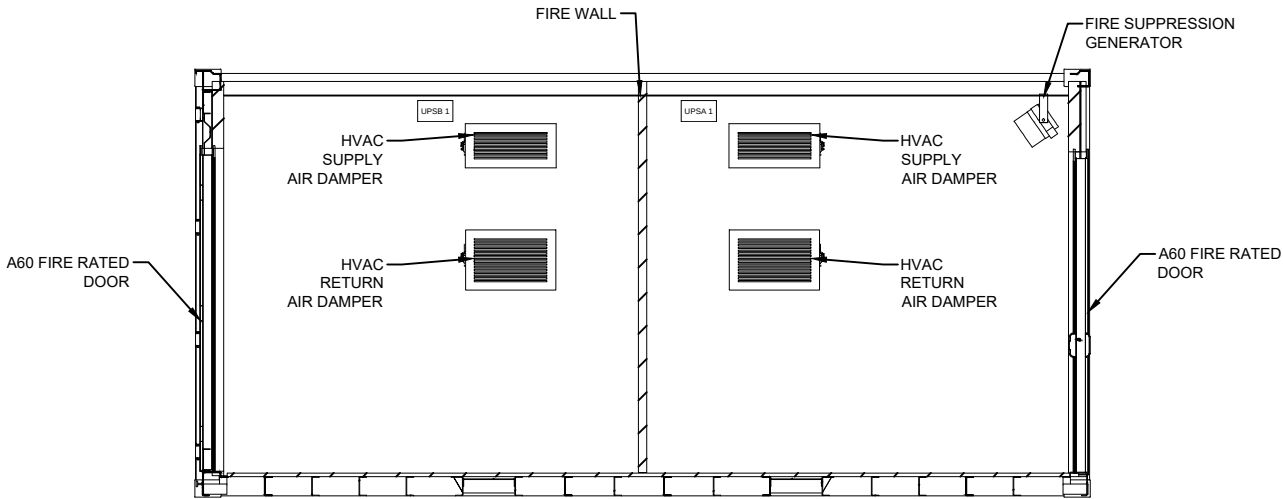

SECTION C-C

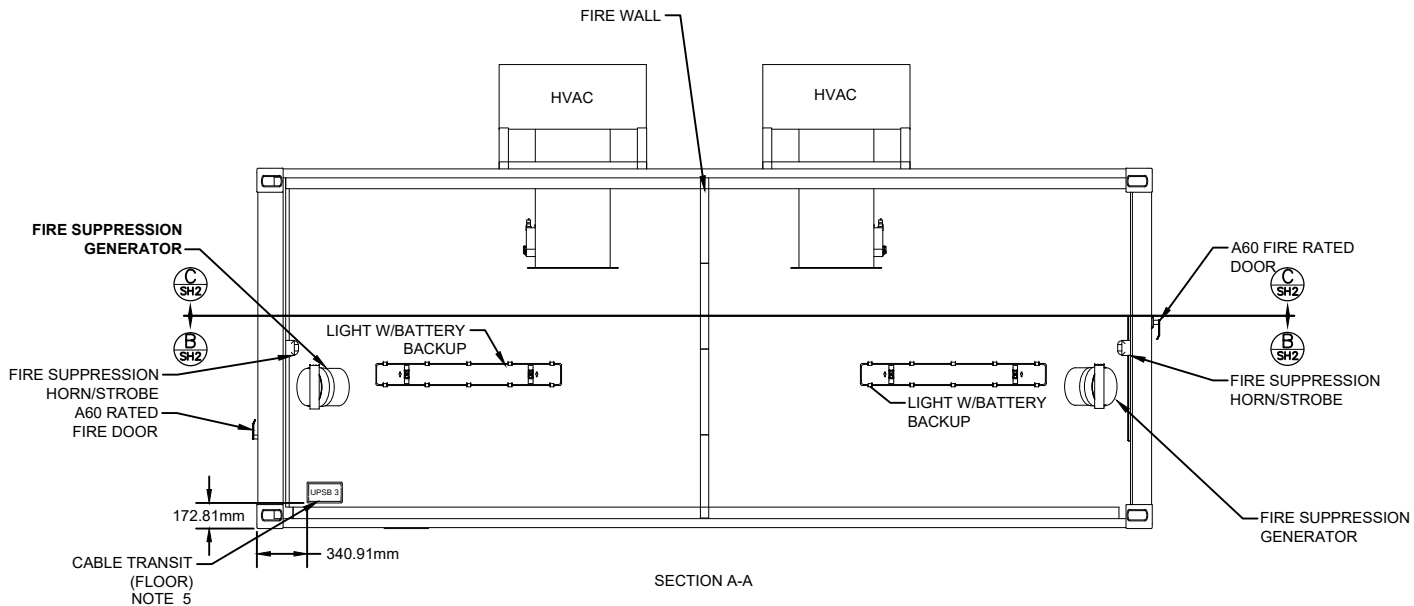

SECTION A-A

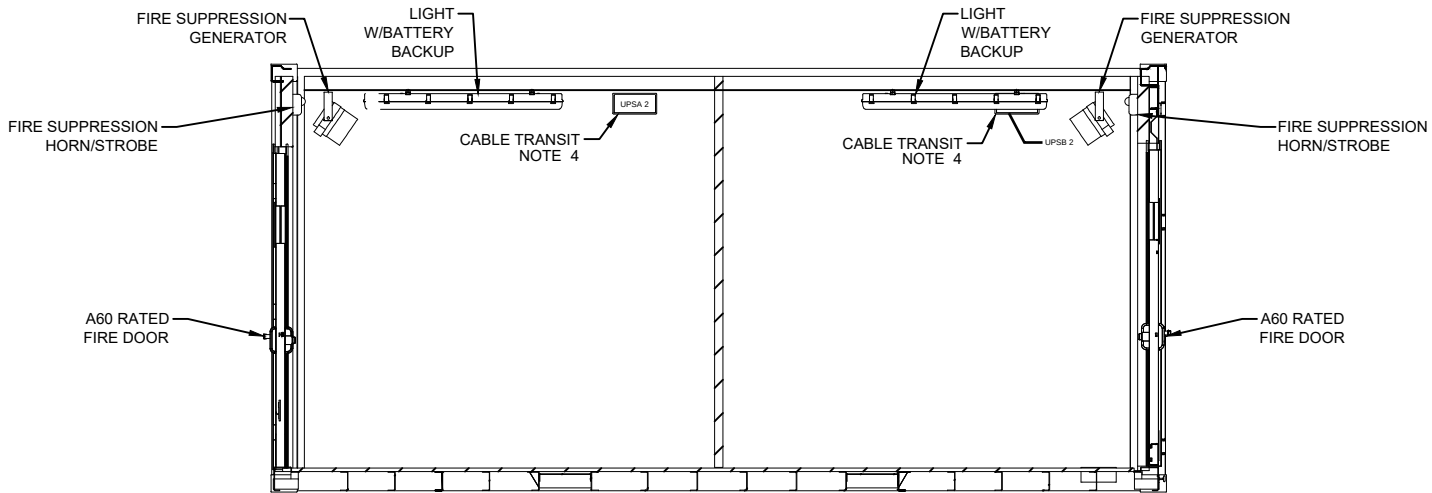


SECTION B-B

NOTES

1. FOR FITTING PURPOSES ONLY. NOT FOR CONSTRUCTION.
2. DRAWING SCALE IS APPROXIMATE.
3. CONTAINER CONSTRUCTED TO A60 FIRE RATING.
4. SOUTH SIDE TRANSITS TO ALIGN WITH BCC NORTH SIDE TRANSITS WHEN CONTAINERS ARE POSITIONED SIDE BY SIDE.
5. FLOOR TRANSIT TO ALIGN WITH EEC 'B' CEILING TRANSIT WHEN CONTAINERS ARE STACKED.

LEGEND

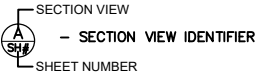

REVISIONS

REV	DESCRIPTION	DSG	DRW	CHK	APP	DATE
A00	ISSUED FOR INFORMATION	TJL	LAP	KAP	MAC	APR 07, 2020
B00	ISSUED FOR CONSTRUCTION	RLF	LAP	RLF	MAC	APR 07, 2020
B01	EARTH BOSS AND TRANSIT DETAILS ADDED	RLF	LAP	RLF		
C00	AS BUILT	RLF	LAP	TKH	TKH	FEB 26, 2021
C01	REVISED AS BUILT	RLF	LAP	TKH	TKH	AUG 02, 2021

ENGR SEAL

ENGR PERMIT

AVALON

12 PANTHER PLACE
MOUNT PEARL, NL, CANADA A1N 5B1
PH: 709-364-5111
FAX: 709-364-6616
WWW.AVALONCONTROLS.CA

NOTICE
THIS DRAWING AND ALL ITS
CONTENTS REMAIN THE
PHYSICAL AND
INTELLECTUAL PROPERTY OF
AVALON CONTROLS LTD.
AND IT SHALL NOT BE
COPIED OR DISTRIBUTED
WITHOUT THE CONSENT OF
THE COMPANY.

CLIENT	SDP GP WEST WHITE ROSE PROJECT	PROJECT	649353 WEST WHITE ROSE PROJECT S-A2501 ICS AND EDS/ECMS
--------	--------------------------------------	---------	---

TITLE
120/208V UPS CABIN
MECHANICAL GENERAL ARRANGEMENT
DIAGRAM

SCALE	NTS	DWG NO.	15045-13-E-GA-002	SHEET	2	OF	2	REV	C00
-------	-----	---------	-------------------	-------	---	----	---	-----	-----

ALL PRINTED COPIES OF THIS DRAWING ARE CONSIDERED UNCONTROLLED